


MD 710 IS ASSUMED TO RUN  
IN AN EAST-WEST DIRECTION


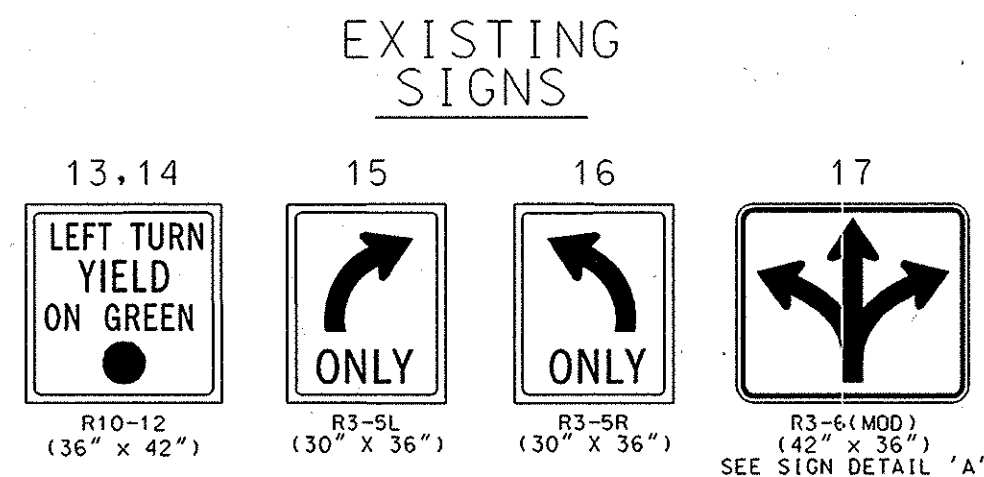


PROPOSED VIDEO  
DETECTION CAMERAS

EXISTING VIDEO  
DETECTION CAMERAS  
TO BE REMOVED


VIDEO  
DETECTION  
ZONE

EXISTING  
SIGNAL HEADS

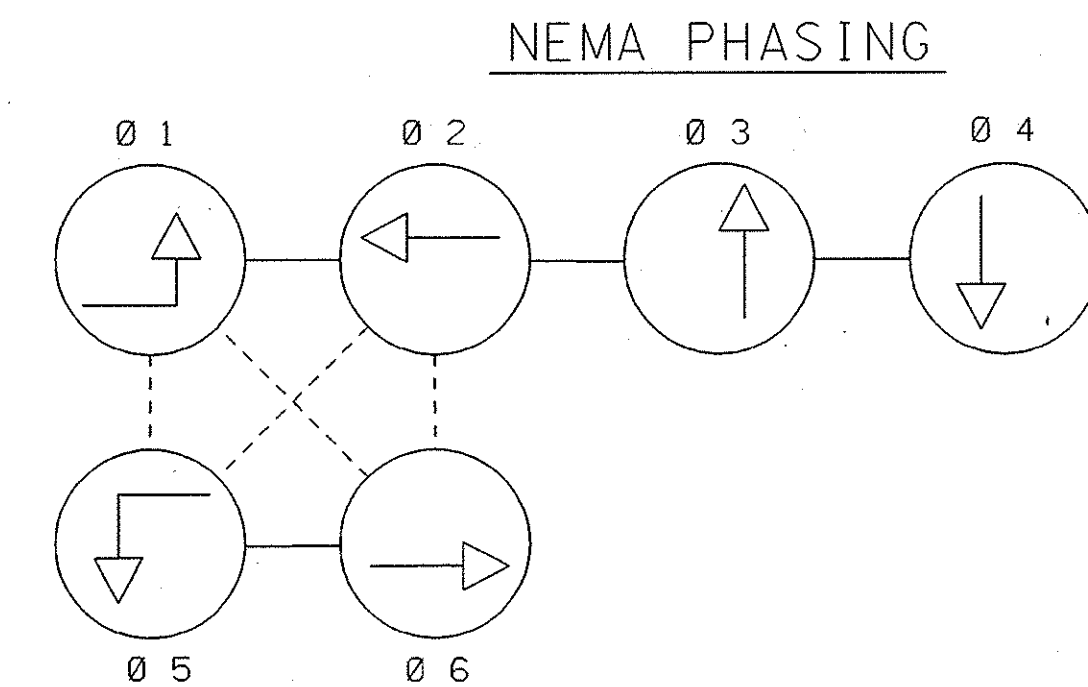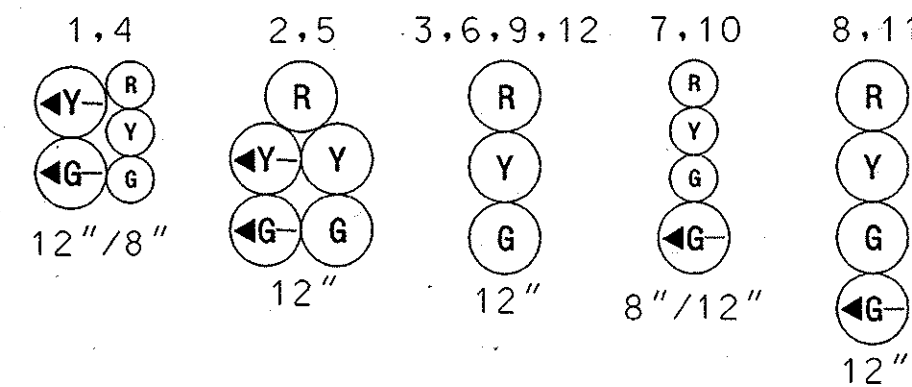

PHASING NOTES:

- PHASES ASSOCIATED BY A SOLID LINE WILL NOT OPERATE CONCURRENTLY.
- PHASES ASSOCIATED BY A DASHED LINE WILL OPERATE CONCURRENTLY.

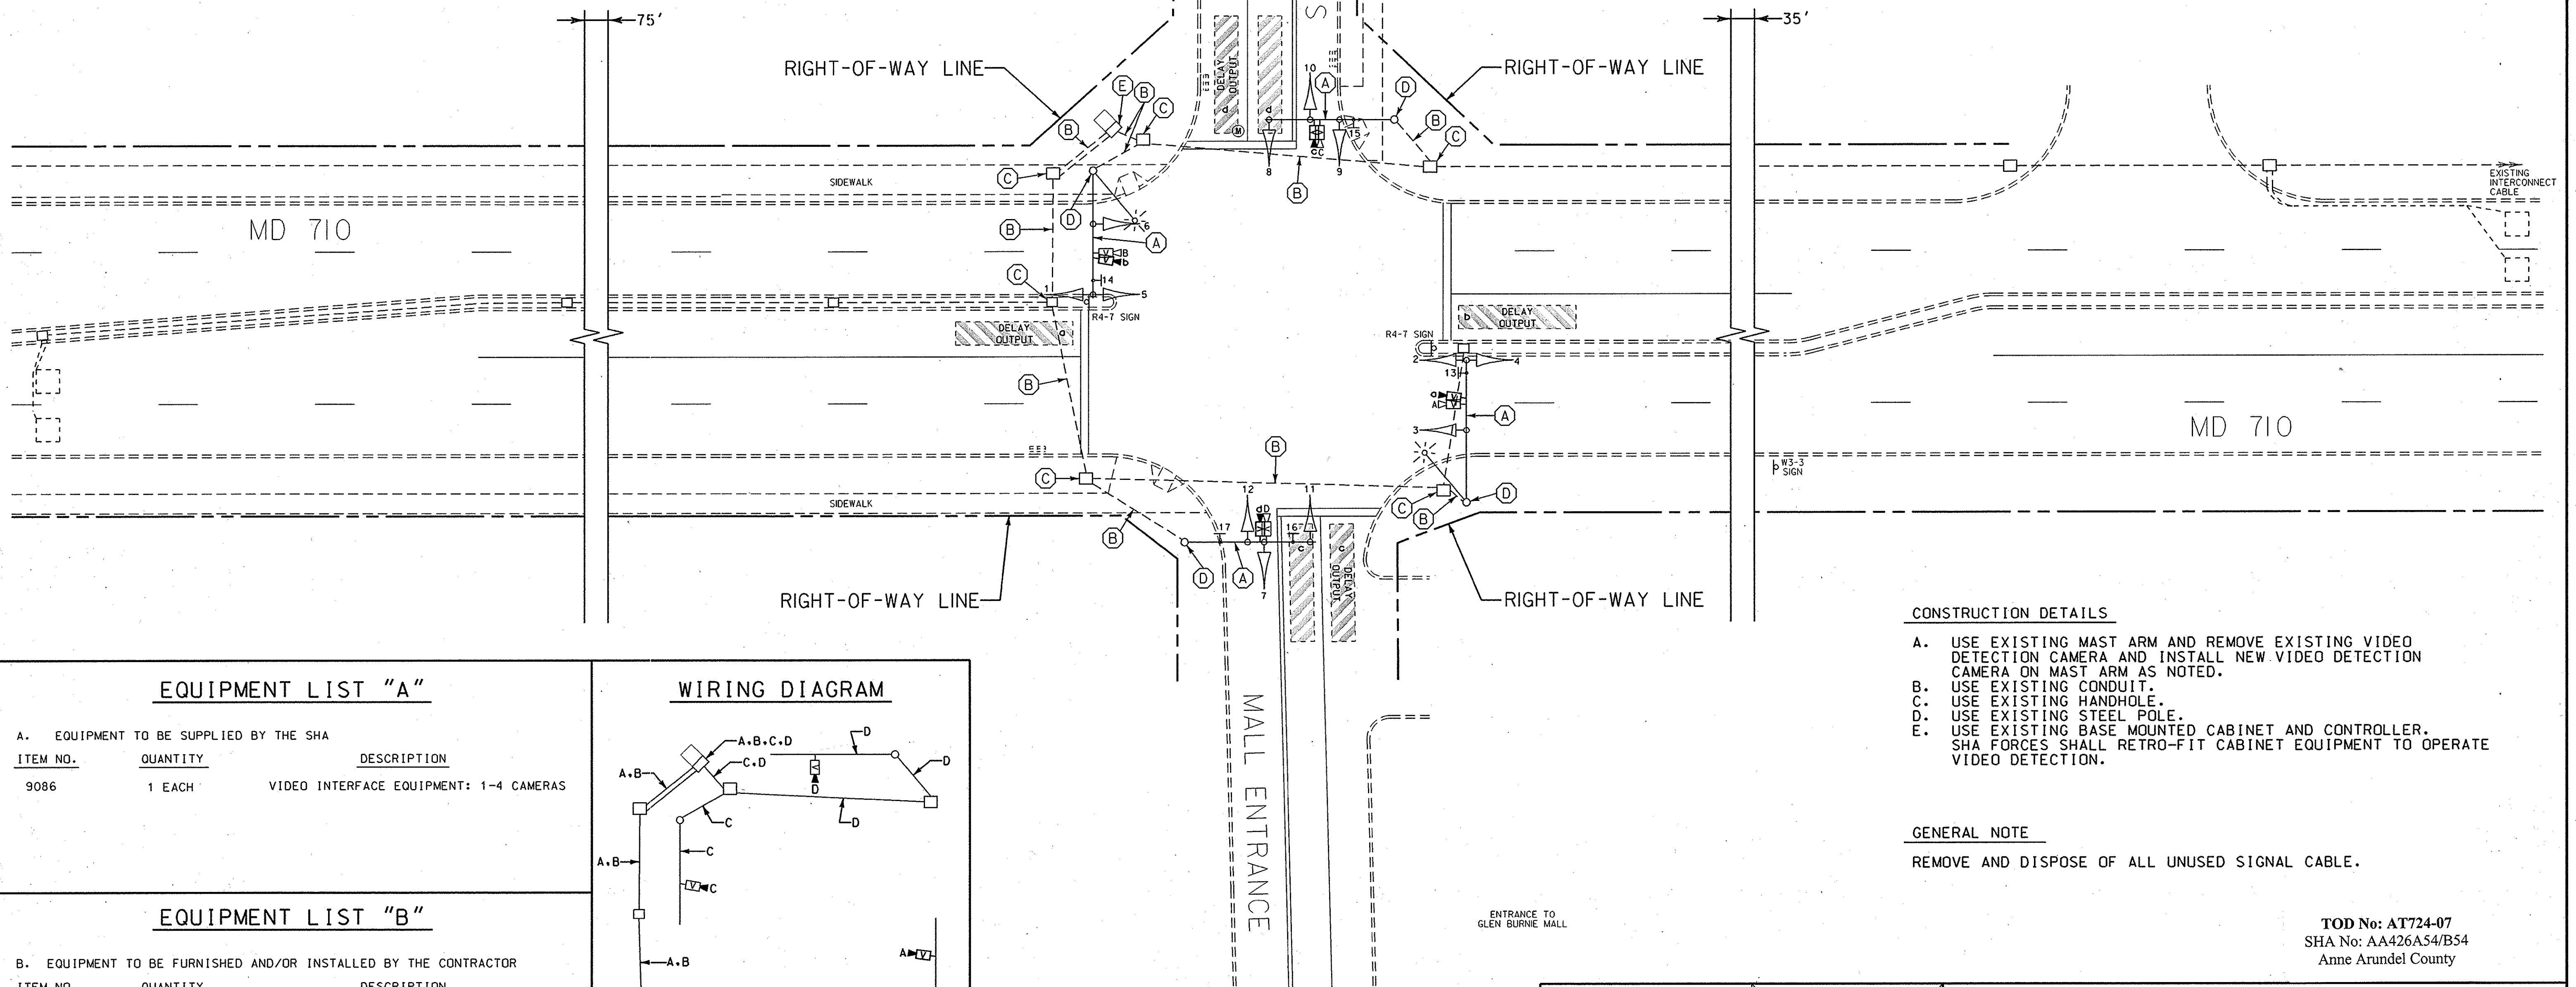

EQUIPMENT LIST "A"

A. EQUIPMENT TO BE SUPPLIED BY THE SHA


ITEM NO.	QUANTITY	DESCRIPTION
9086	1 EACH	VIDEO INTERFACE EQUIPMENT: 1-4 CAMERAS

EQUIPMENT LIST "B"

B. EQUIPMENT TO BE FURNISHED AND/OR INSTALLED BY THE CONTRACTOR

ITEM NO.	QUANTITY	DESCRIPTION
1001	1 EACH	MAINTENANCE OF TRAFFIC
8004	1 EACH	REMOVE AND DISPOSE OF EXISTING MATERIAL AND EQUIPMENT AS PER ASSIGNMENT
8026	4 EACH	VIDEO DETECTION CAMERA
8027	3 EACH	CONTROL CABLE, 250 FT. VIDEO DETECTION CAMERA TO CONTROLLER
8028	1 EACH	CONTROL CABLE, 500 FT. VIDEO DETECTION CAMERA TO CONTROLLER

WIRING DIAGRAM

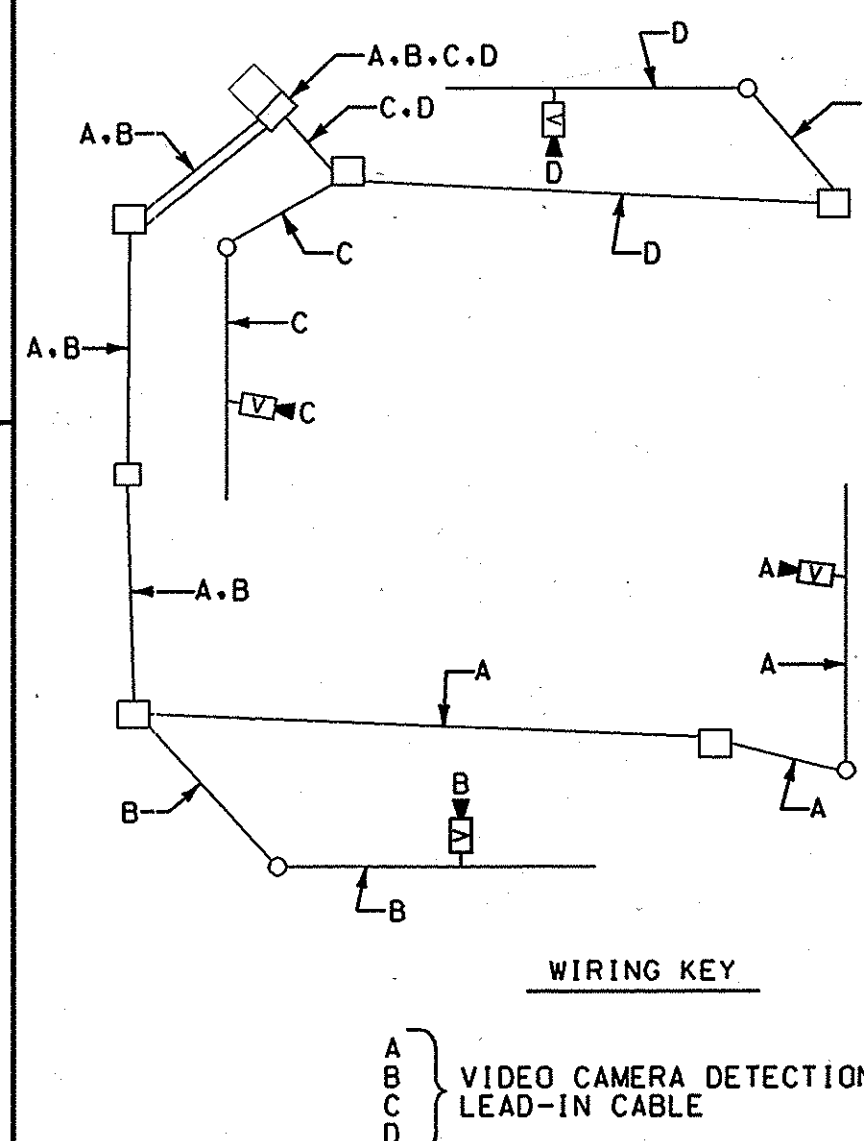

LEGEND OF UNDERGROUND  
AND OVERHEAD UTILITIES

AERIAL CABLE	—
ELECTRICAL	—
TELEPHONE	—
GAS	—
SEWER	—
STORM DRAIN	—
WATER	—
CABLE TV	—

Whitman, Reardon and Associates, LLP

801 South Caroline Street  
Baltimore, Maryland 21231  
(410) 235-3450

REVISIONS
① REPLACED VIDEO DETECTION CAMERAS CONTRACT NO. AT7245185
SRB NML 3/06
② SPLIT SIDE STREETS
CJS MAR 02 10/02
③ REPLACE DAMAGED DETECTION, ADD MAINLINE LOOP DETECTORS
SRB NML 4/99
ASBUILT 7/83
JBB

APPROVALS
TEAM LEADER - TRAFFIC ENGINEERING DESIGN DIVISION
ASST. TRAFFIC ENGINEERING DESIGN DIVISION
CHIEF TRAFFIC ENGINEERING DESIGN DIVISION
DIRECTOR, TRAFFIC & SAFETY



MD 710 (E. ORDNANCE RD.) & GB MALL ENT.

DRAWN BY: J. BOLING	F.A.P. NO. 374-D	TS NO. 374-D	SHEET NO. 1 OF 1
CHECKED BY: J. BOLING	S.H.A. NO. 23854T2502856	T.I.M.S. NO. H776	
SCALE: 1" = 20'	COUNTY: ANNE ARUNDEL	LOG MILE: 02071000.20	
DATE: 11/72			